



LEGEND - TELKOM		
ITEM	EXISTING	NEW
1 x 110mm uPVC PIPE		
2 x 110mm uPVC PIPE		
ACCESSIBLE PIPE JUNCTION BOX		

NOTES:
 1. ALL PLANT INDICATED NOT TO SCALE.
 2. ALL PIPES AND ACCESSIBLE PIPE JUNCTION BOXES TO BE SUPPLIED AND INSTALLED BY CONTRACTOR, AT NO COST TO TELKOM.
 3. DRAWWIRE TO BE INSTALLED IN ALL PIPES.

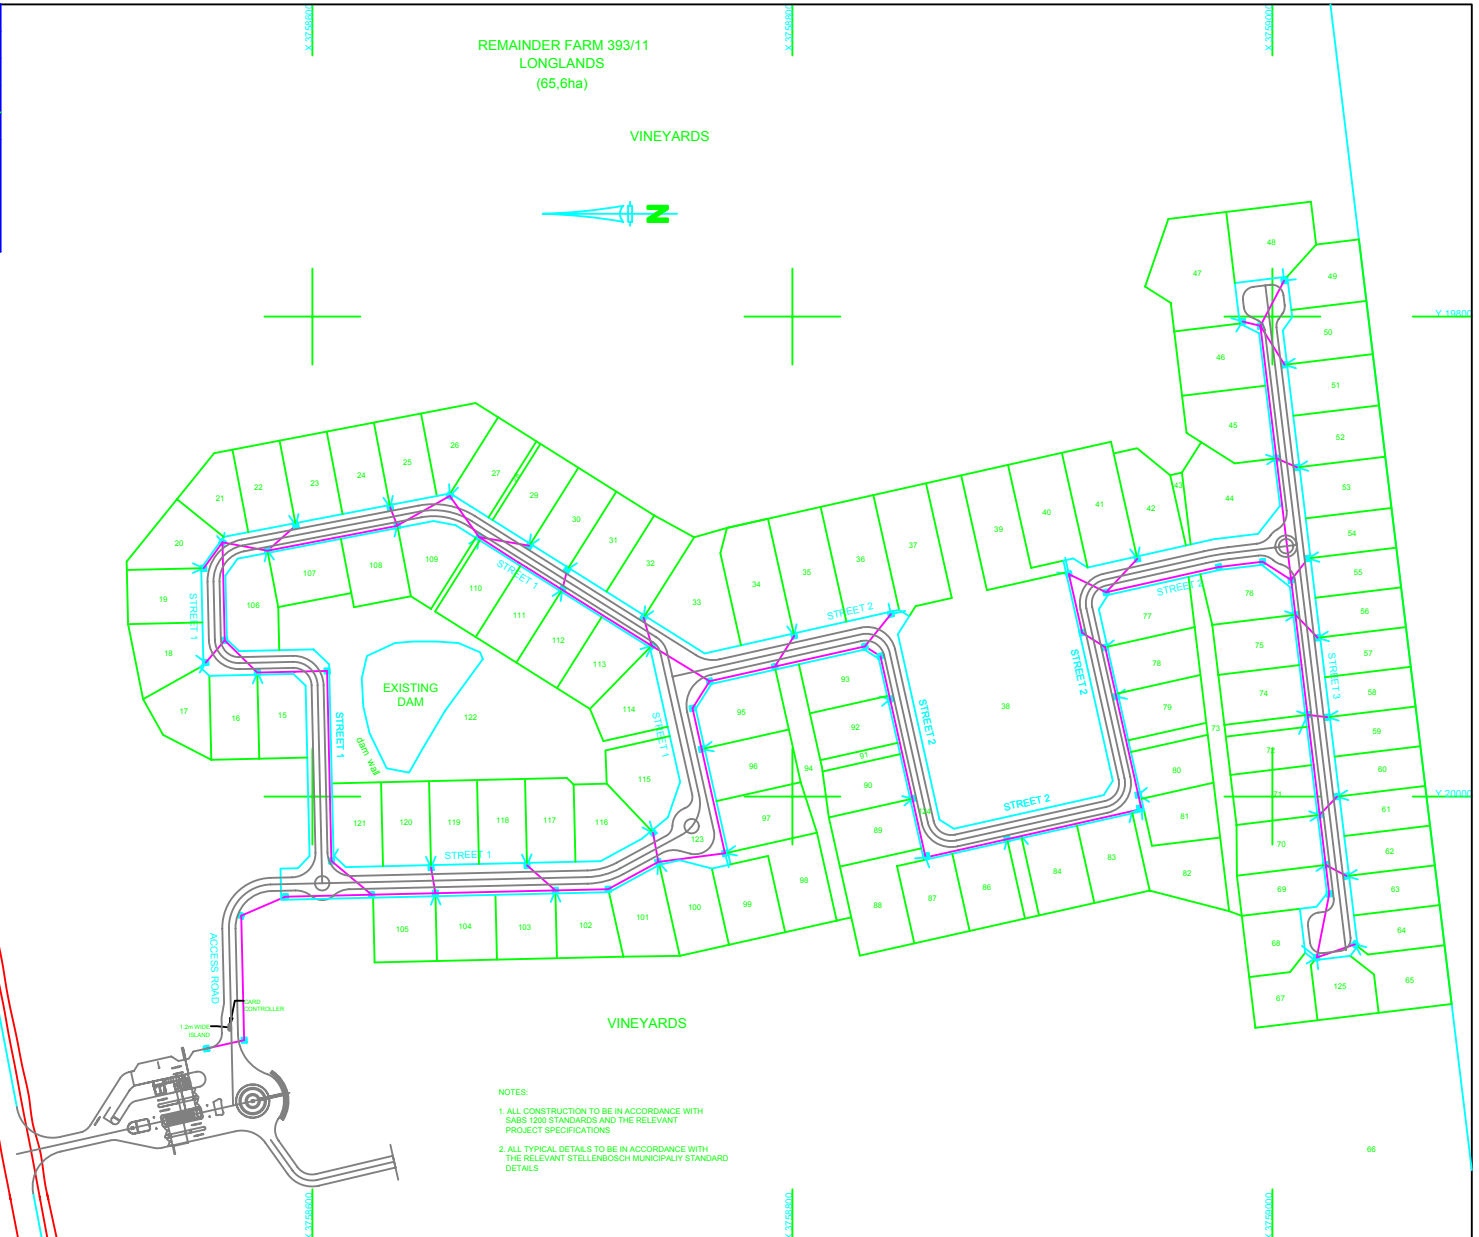

NOTES:
 1. ALL CONSTRUCTION TO BE IN ACCORDANCE WITH SARS 1209 STANDARDS AND THE RELEVANT PROJECT SPECIFICATIONS
 2. ALL TYPICAL DETAILS TO BE IN ACCORDANCE WITH THE RELEVANT STELLENBOSCH MUNICIPALITY STANDARD DETAILS

Amendment		Description	
No.	Date	Checked	Done By
1	2009/05	F.O.	TELKOM LAYOUT AMENDED
2	2009/05	P.D.	TELKOM LAYOUT AMENDED
3	2009/05	EDW	ACCESS ROAD ADDED AND TELKOM AMENDED
4	2009/05	EDW	TELKOM LAYOUT AND ERF LAYOUT AMENDED
5	2009/05	EDW	AS BUILT

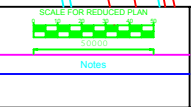

Designed: A.A.
 Drawn: EDW
 Checked:

P.O. Box 398
 Bellville 7535
 Tel: (021) 912-3000
 Fax: (021) 912-3222
 e-mail: capetown@kvl.co.za

Consulting Engineer	Pt Eng
Date:	
Client	
Date:	

Client:
LONGLANDS HOLDINGS (Pty) Ltd

Project:
CIVIL ENGINEERING SERVICES FOR LONGLANDS COUNTRY ESTATE

Drawing description:
TELKOM LAYOUT

Scale: 1:1000
 Date: MAY 2009
 Drawing number: 20815BKS0/06 E