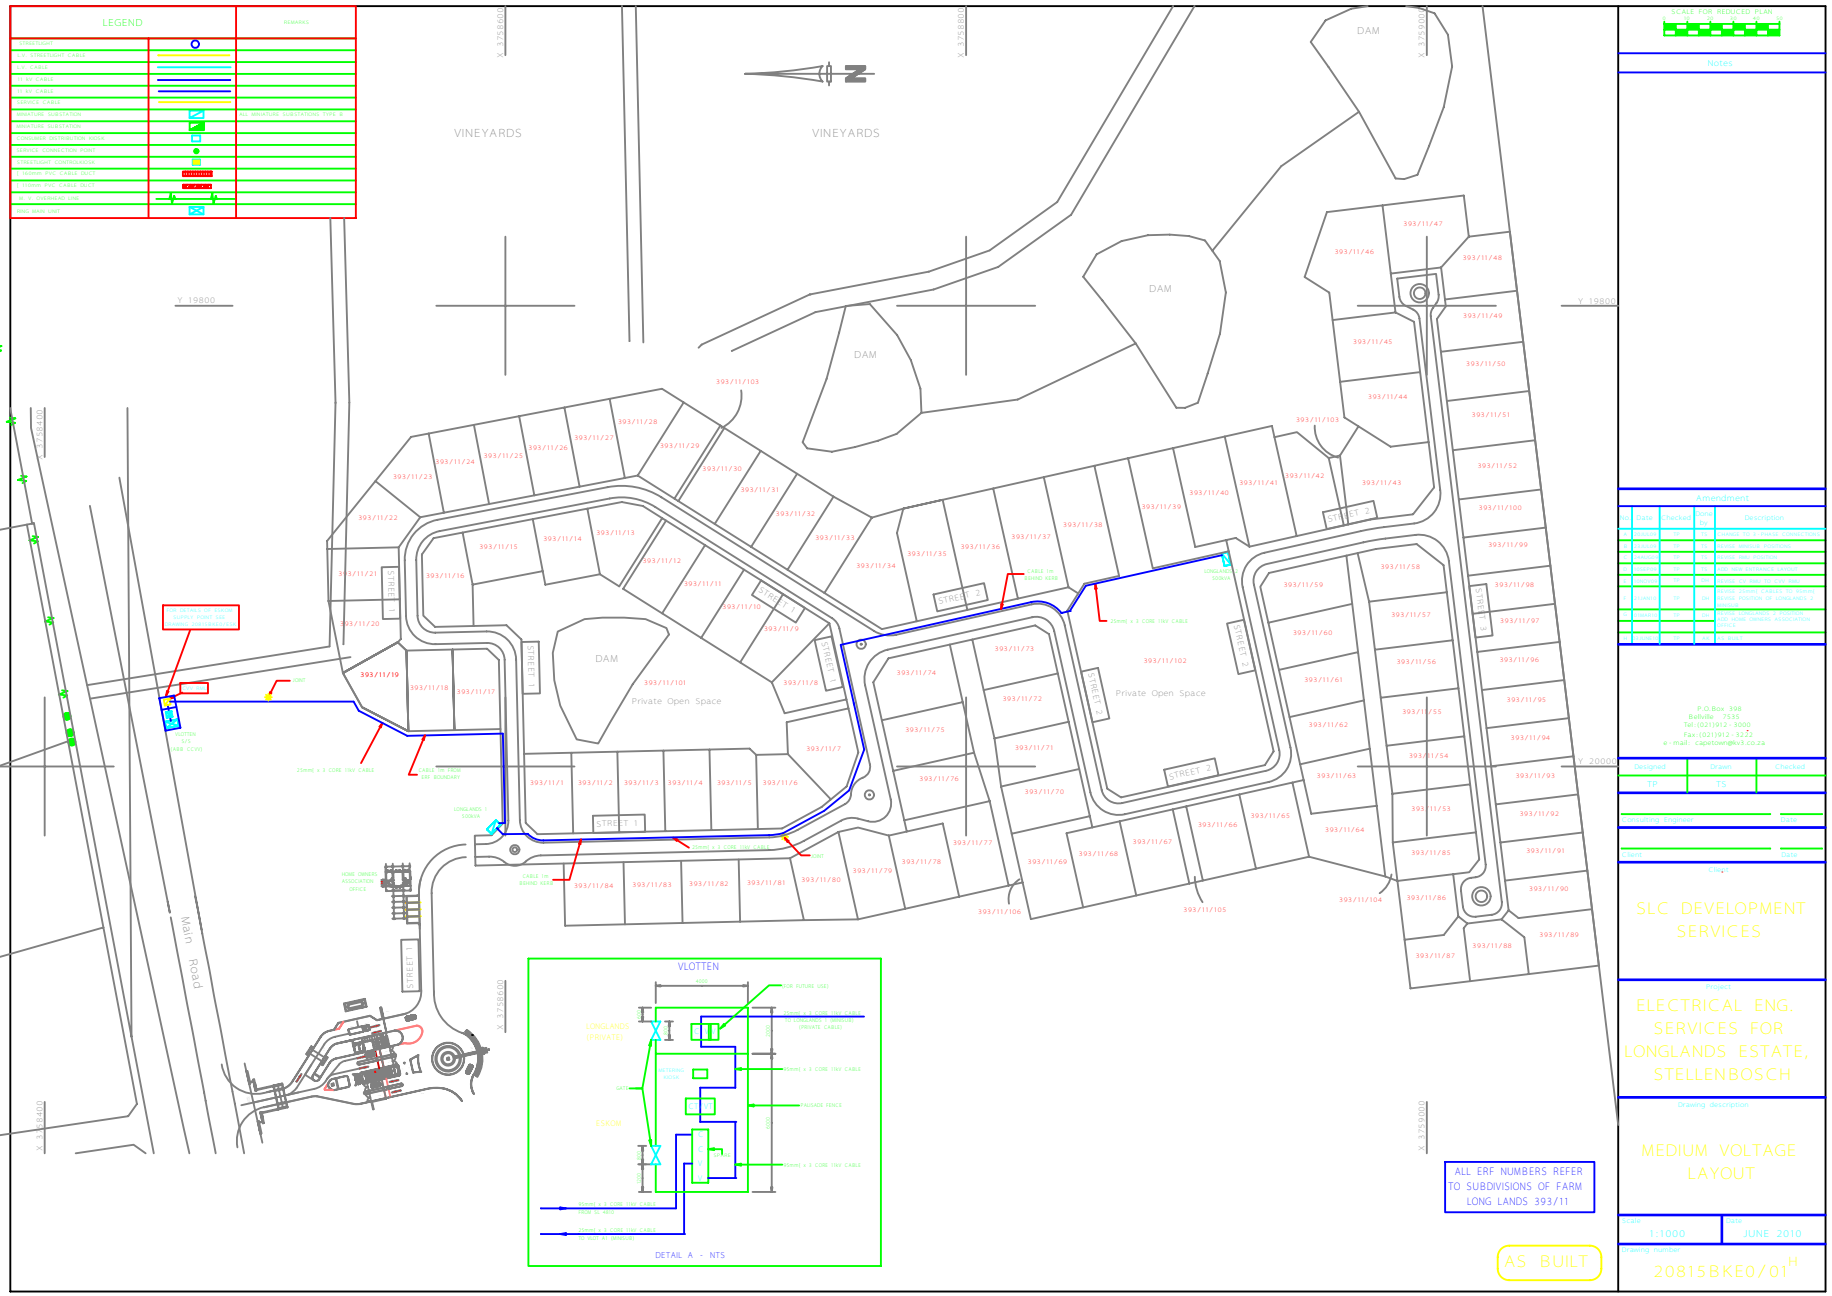
LEGEND
REMARKS
VINEYARDS
VINEYARDS
DAM
DAM
DAM
DAM
Private Open Space
Private Open Space
STREET 1
STREET 2
Main Road
VLOTTEN
DETAIL A - NTS
ALL ERF NUMBERS REFER TO SUBDIVISIONS OF FARM LONG LANDS 393/11
AS BUILT
SCALE FOR REDUCED PLAN
Notes
Amendment
P.O.Box 398
Bellville 7535
Tel:(021)912 - 3000
Fax:(021)912 - 3222
e-mail: capetown@ss3.co.za
Designed
Drawn
Checked
TP
TS
Approved by Engineer
Date
Client
Date
SLC DEVELOPMENT SERVICES
Project
ELECTRICAL ENG. SERVICES FOR LONGLANDS ESTATE, STELLENBOSCH
Drawing description
MEDIUM VOLTAGE LAYOUT
Scale
1:1000
Date
JUNE 2010
Drawing number
20815BKE0/01
H